

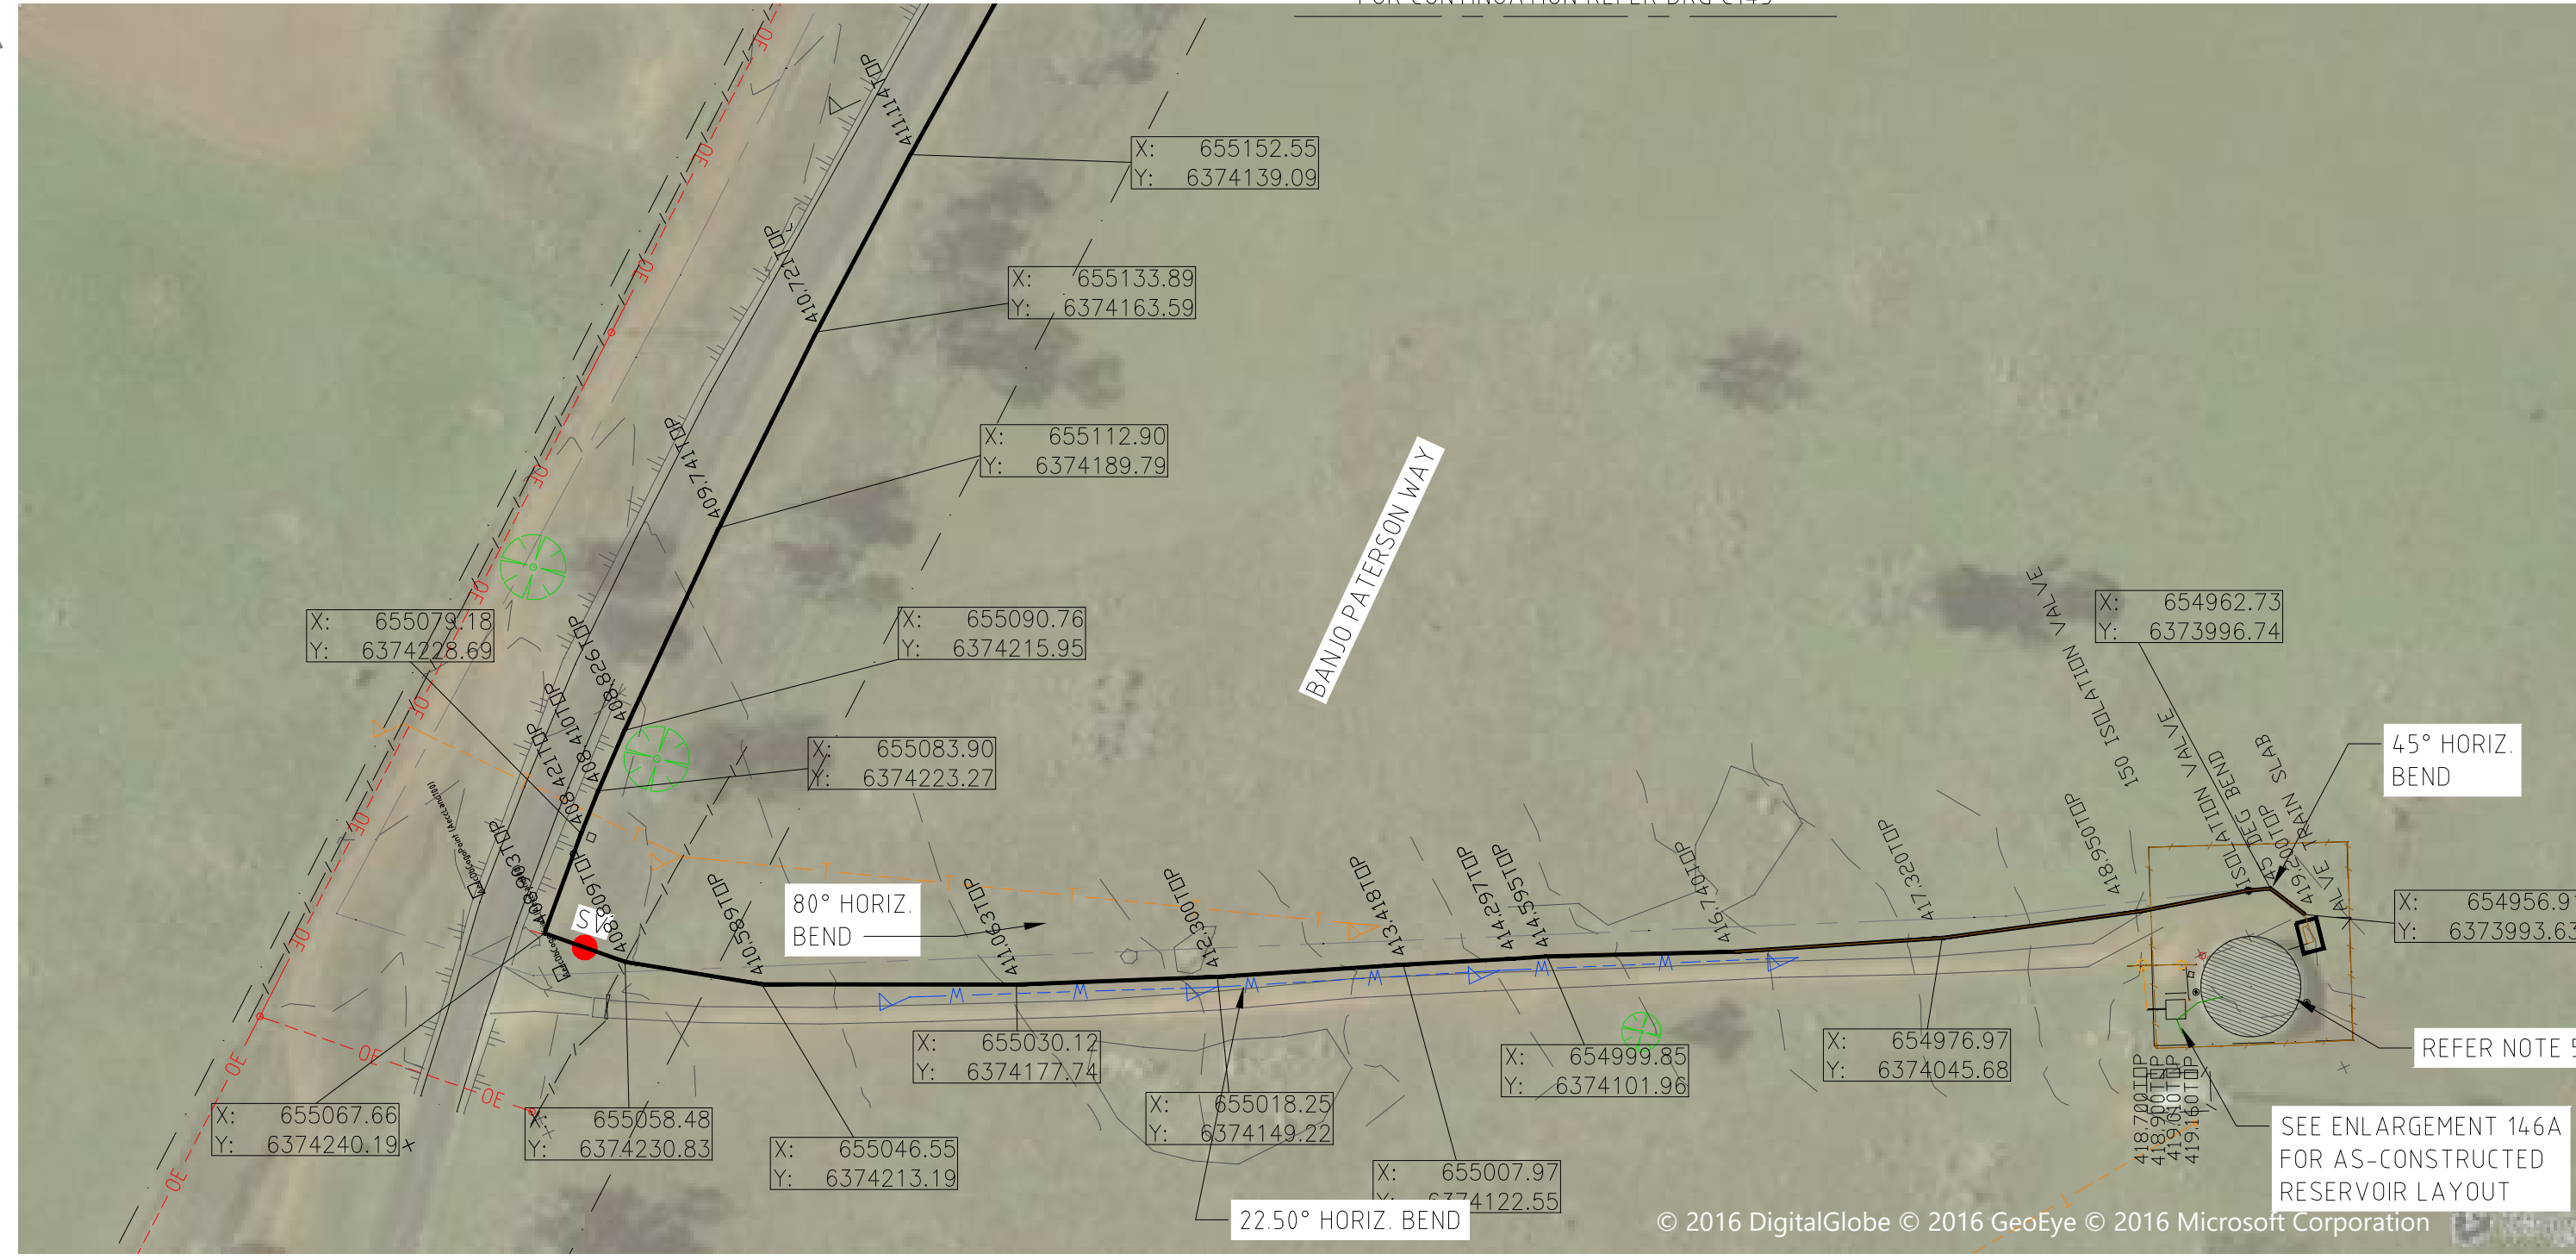


200 mm DO NOT SCALE - IF IN DOUBT, ASK


ORIGINAL SIZE A1

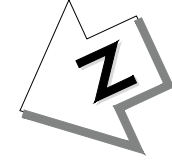

PLAN
SCALE 1 : 1000

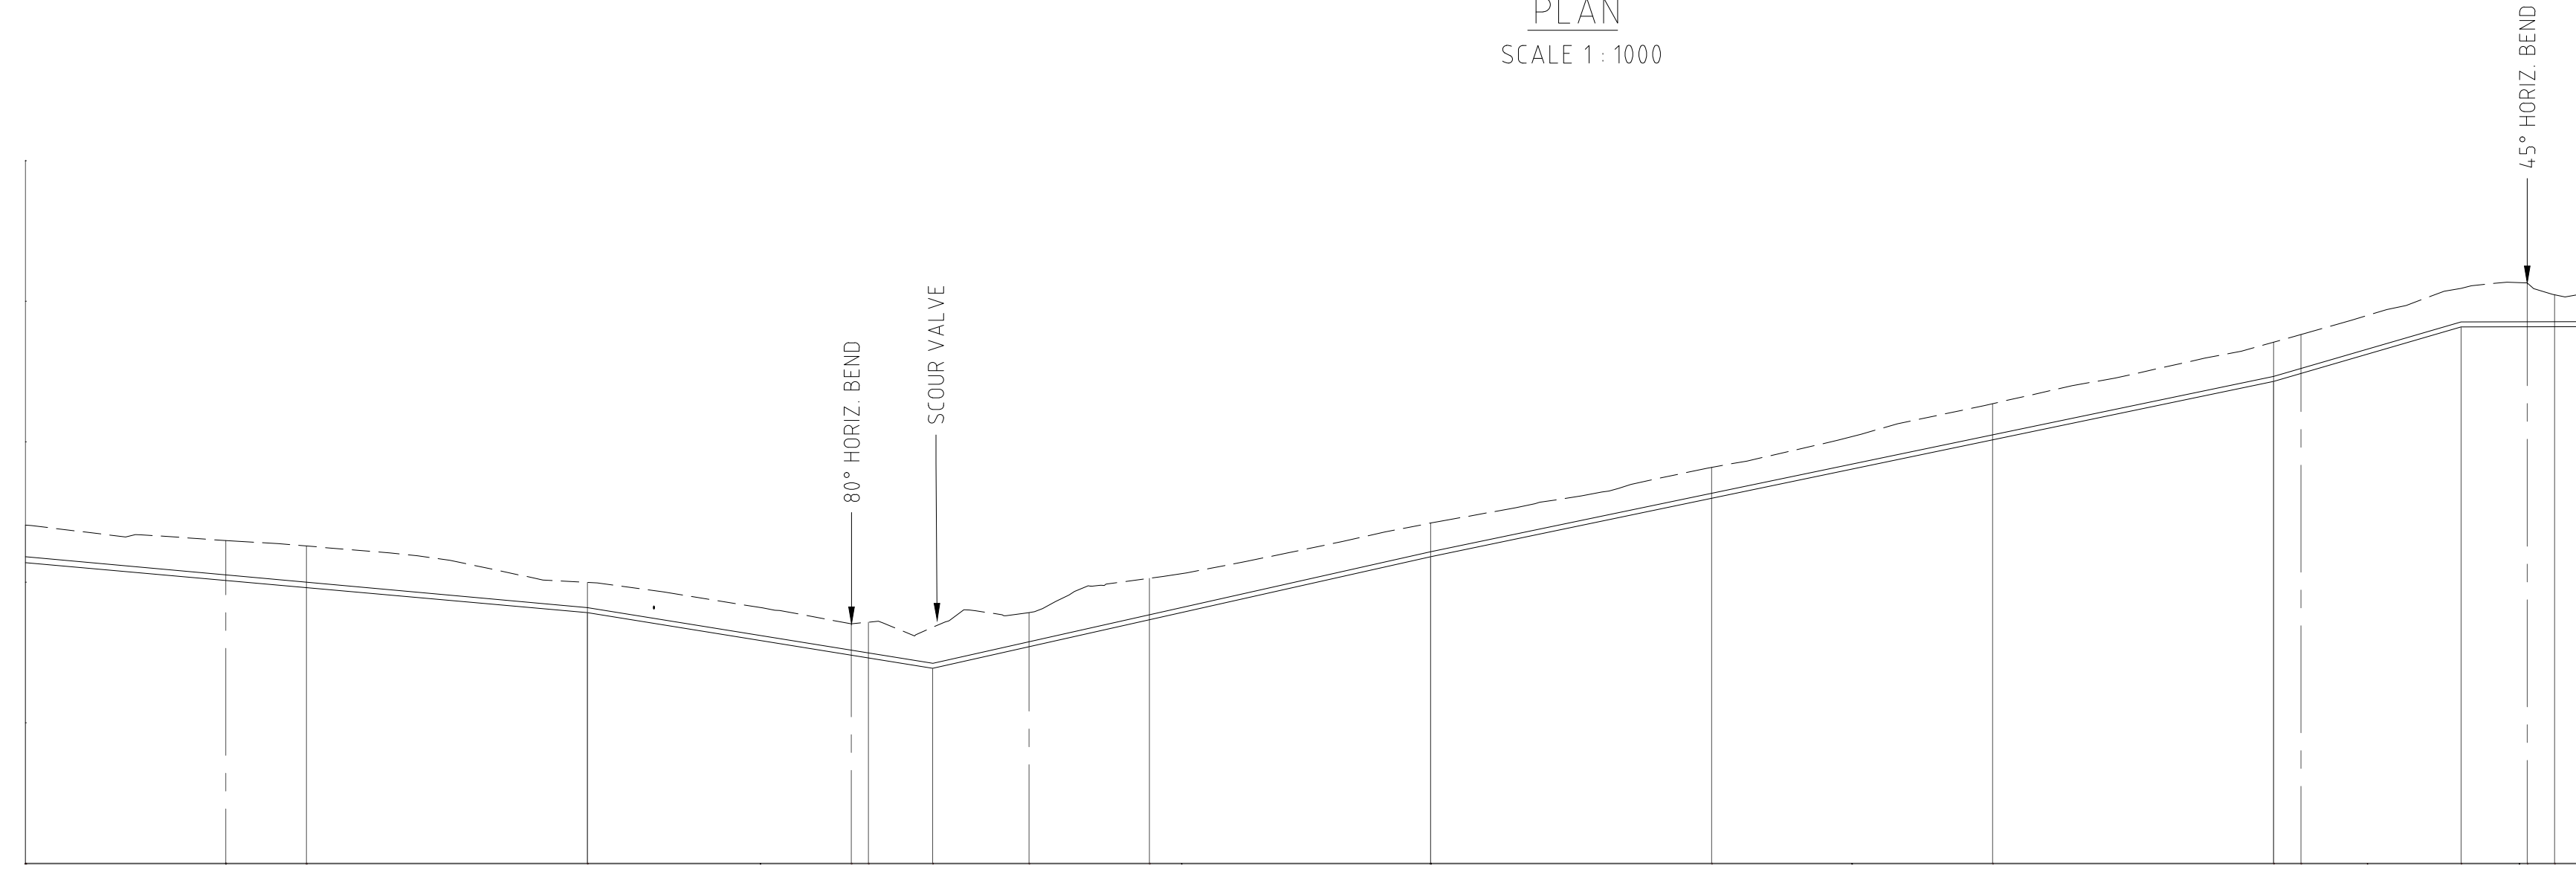

LONGITUDINAL SECTION
SCALES - H 1 : 1000
V 1 : 200

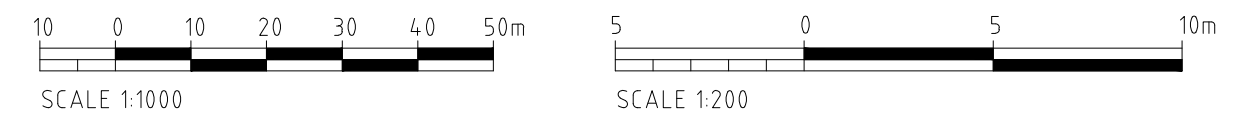

ENLARGEMENT 146A
NOT TO SCALE



CONFIRMATION OF SERVICE LOCATION
NOTWITHSTANDING THAT THE PRESENT OR PROPOSED POSITIONS OF UNDERGROUND SERVICES MAY BE INDICATED ON THE DRAWINGS, THEIR POSITION AND DEPTH IS APPROXIMATE ONLY. PRIOR TO ANY EXCAVATION THE CONTRACTOR SHALL CONTACT ALL RELEVANT AUTHORITIES AND SHALL POT-HOLE ALL SERVICES TO OBTAIN EXACT LOCATIONS. THE CONTRACTOR SHALL NOTIFY THE SUPERINTENDENT OF ANY CONFLICTS BETWEEN THE PROPOSED MAIN AND THE EXISTING SERVICES.

LEGEND

- PROPOSED PIPELINE
- CADASTRAL BOUNDARY
- EXISTING FENCE
- EXISTING TELSTRA
- ELECTRICITY - O/H
- EXISTING SEWER
- EXISTING DRAIN
- EXISTING WATER
- EXISTING STORMWATER
- CONTOUR LINE
- EDGE OF BITUMEN
- EDGE OF FORMATION
- EXISTING TREE
- AV AIR VALVE
- SV SCOUR VALVE
- IS ISOLATION VALVE
- BH 40 BOREHOLE
- HDD HORIZONTAL DIRECTIONAL DRILLING
- P SIGN

NOTES:

1. ALL DIMENSIONS AND LEVELS SHOWN IN METERS UNO
2. REFER TO DRG NO. 83503550-01-001-G003 FOR GENERAL NOTES.
3. REFER TO DRG NO. 83503550-01-001-G006 FOR SHEET LAYOUT PLAN.
4. AERIAL IMAGERY SOURCED FROM BING MAPS AND IS PROVIDED FOR GUIDANCE ONLY.
5. REFER TO 83503550-01-001-C320 FOR YEOVAL RESERVOIR SITE LAYOUT.

WORK AS EXECUTED
THESE DRAWINGS ARE IN ACCORDANCE WITH THE WORK AS EXECUTED AS AT 30 OCT 2018. IN ACCORDANCE WITH CABONNE COUNCIL STANDARDS.
CONTRACT: 83503550-01-001-G003
NAME: DANIEL BARKER
SCALE: AS SHOWN
DATE: 28 JAN 2018
SIGNED: [Signature]
SUPERVISOR: [Signature]
DATE: 30 OCT 2018
SIGNED: [Signature]
GRADUATE ENGINEER

X	WAE	DB	30-10-18
1	ISSUED FOR CONSTRUCTION	SDS CM JC	16.01.17
REV	REVISIONS	DRN CHK APP	DATE

SURVEYED	Jan Van Herel	09.2016
DESIGNED	Saudagar Sawant	09.2016
DRAWN	Max Dyer	18.01.17
CAD REVIEW	Calum Murray	18.01.17
DESIGN CHECK	Calum Murray	18.01.17
APPROVED	Josh Cody	05.12.17
PROF REGISTRATION		

Client:

MOLONG TO CUMNOCK AND YEOVAL PIPELINE

CUMNOCK RESERVOIR TO YEOVAL RESERVOIR

PLAN AND LONGITUDINAL SECTION - SHEET 47 OF 47

Status Stamp	WORK AS EXECUTED
Date Stamp	30-10-18
Scales	AS SHOWN
Drawing No.	83503550-01-001-C146
Rev.	X